

NOTICE TO MARINERS


Issue date: 26/09/2020

1. **Wet Storage of Export Cable.** Please be advised that Moray Offshore Windfarm (East) Limited (Moray East) has carried out the laying of a subsea power cable between the moray east windfarm site and cable landfall (HDD Ducts near Boyndie. Export cable number no.1 end has been wet stored on the Moray East site and is presently being guarded by Guard Vessel Resolution.

Further details can be found through published NtM-28 issued 28/06/2020.


2. End position of wet-store arrangement N58° 09' 48.54", W2° 42' 58.02"
-

© COPYRIGHT STATEMENT
Moray Offshore Windfarm (East) Limited © 2020. This document is the property of contractors and sub-contractors and shall not be reproduced nor transmitted without prior written approval.

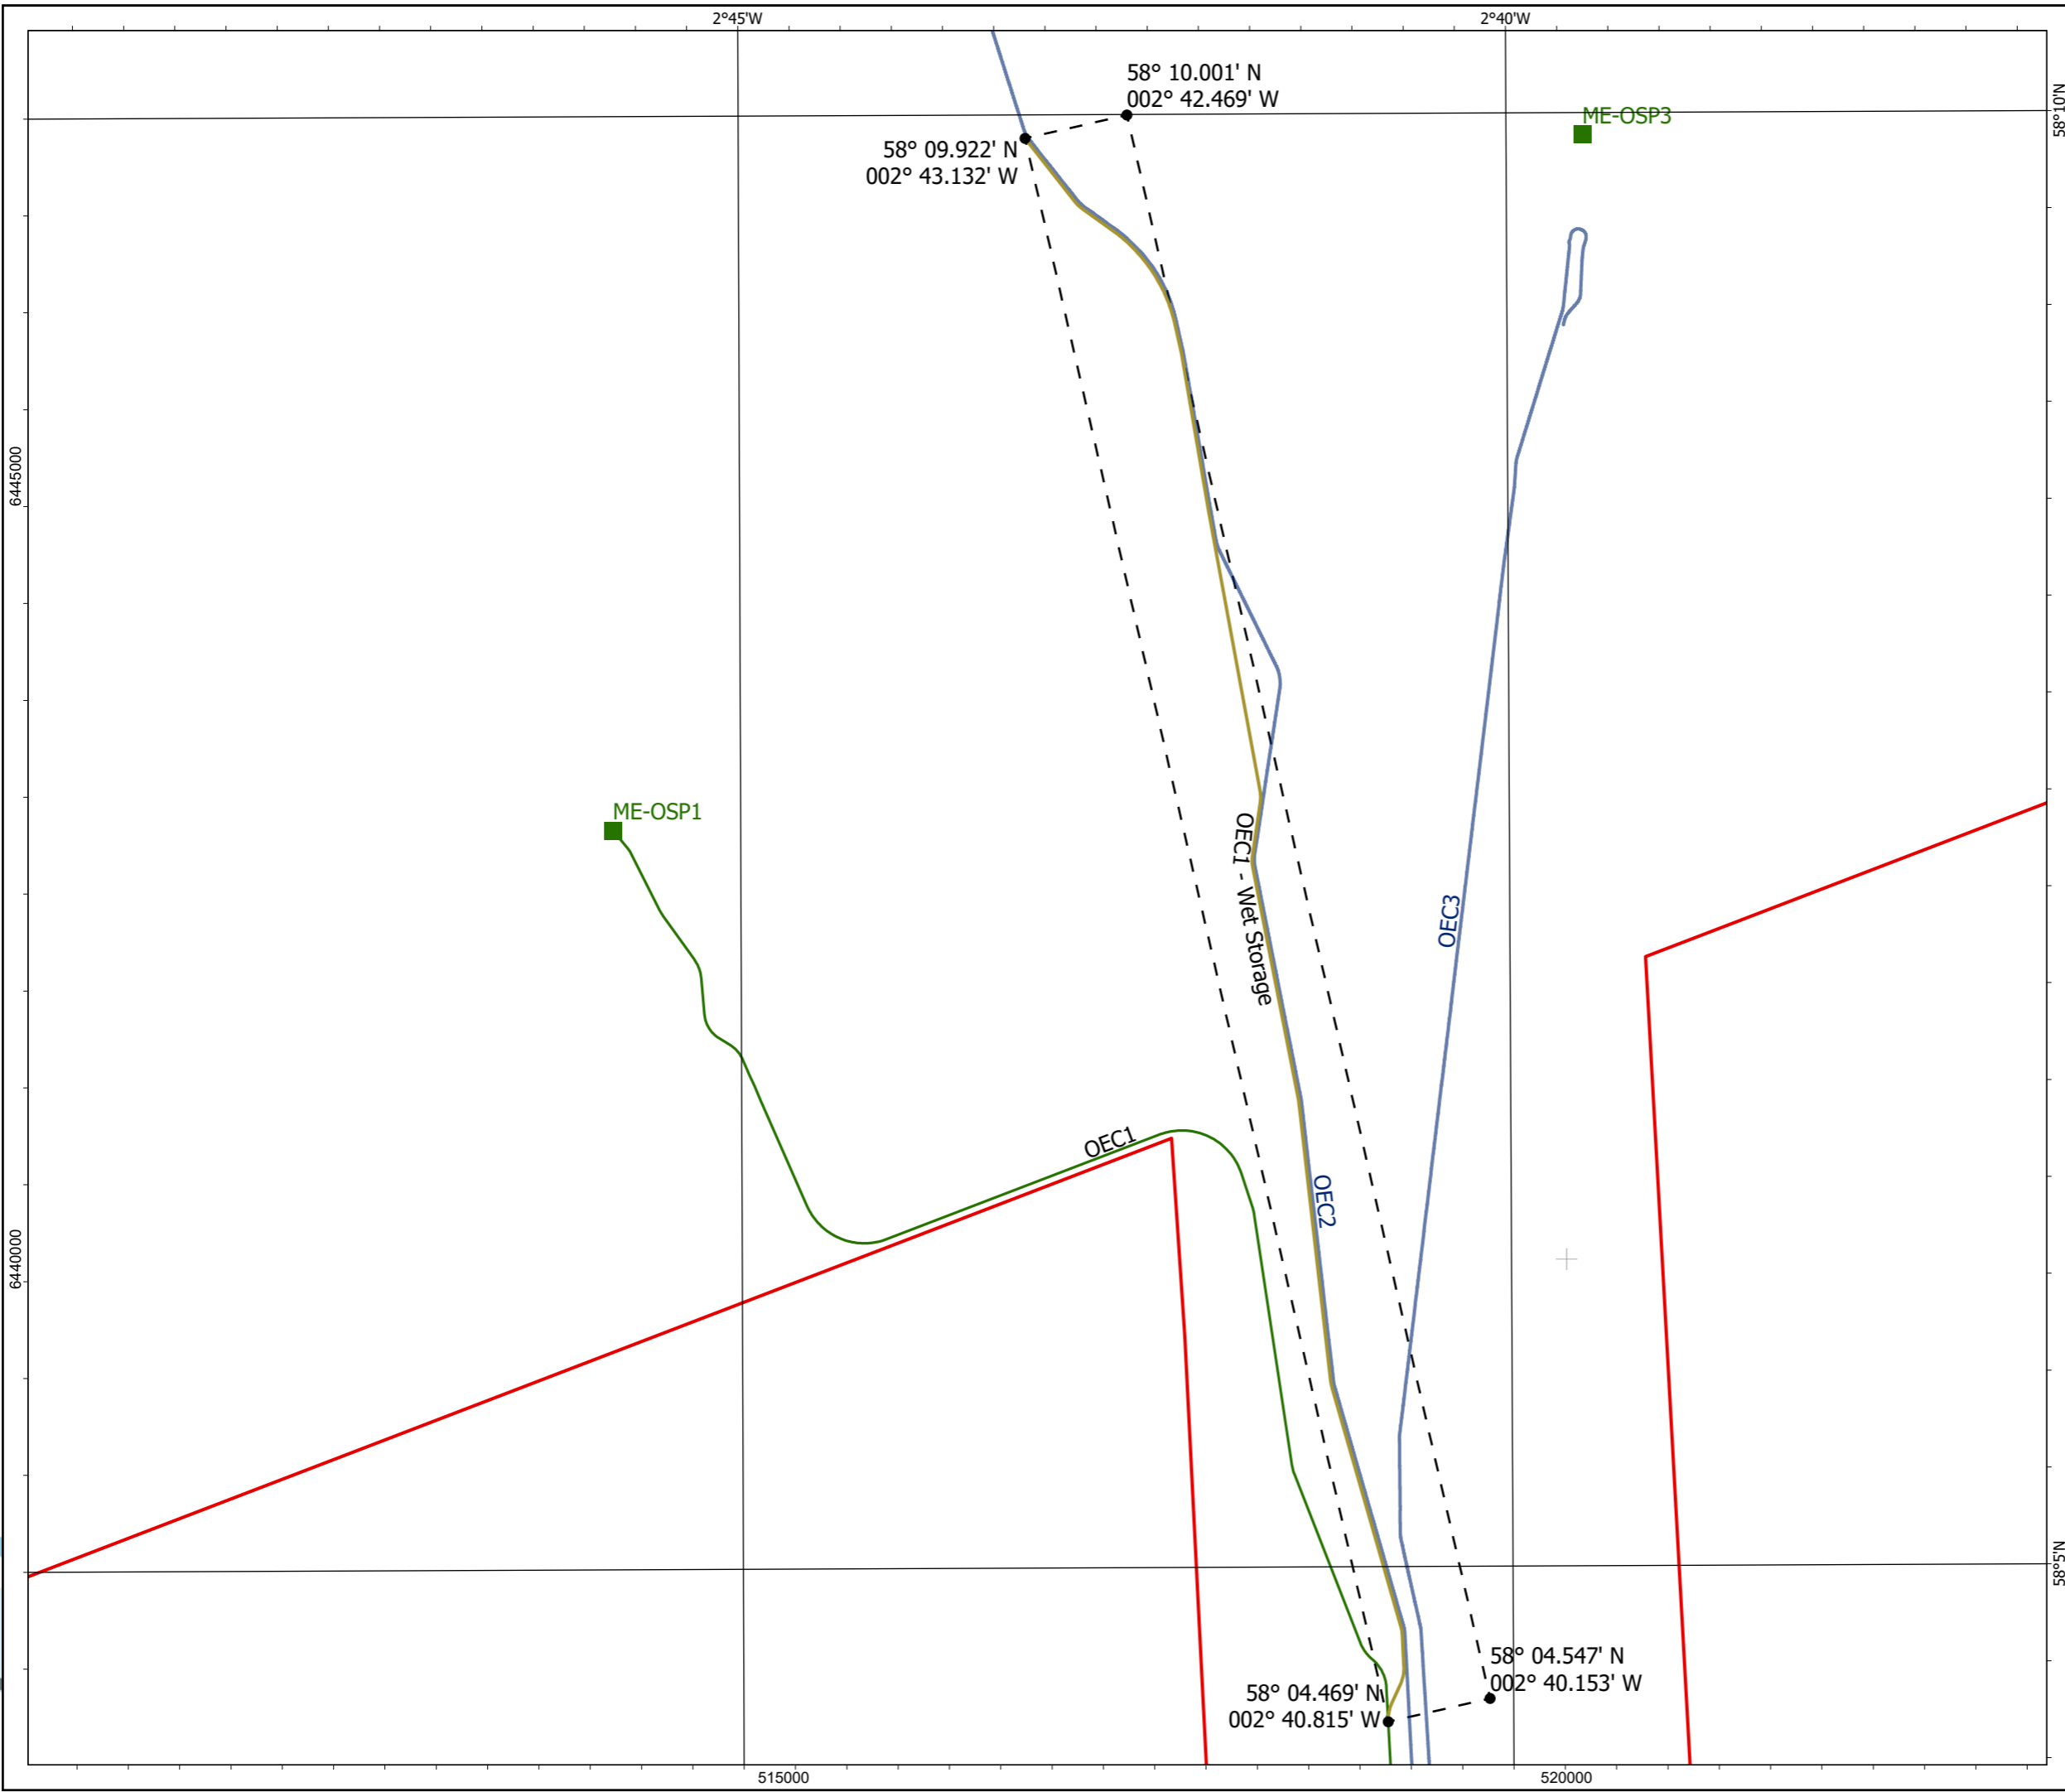

MORAY EAST OFFSHORE WINDFARM

- KEY
- OSP Platform Location
 - Wet Storage Extents
 - Contingency Wet Storage Arrangement
 - As-Laid Cable
 - Proposed Cable Lay
 - - - OEC1 Wet Storage Area
 - Windfarm boundary

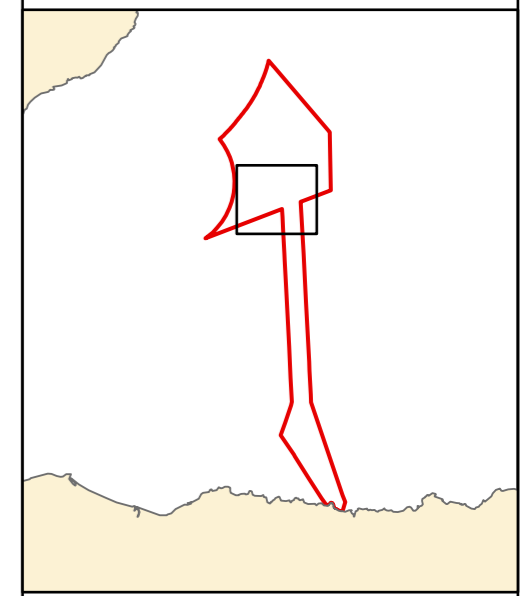

Horizontal Scale: 1:40,000 A3 Chart
0 6,000 12,000 Meters
Geodetic Parameters: WGS84 UTM Zone 30N
Produced: FGI
Reviewed:
Approved:
Date: 25/09/2020 Revision: A
REF:

Offshore Export Cable
Contingency Wet Storage
Arrangement
Moray Offshore
Windfarm (East) Ltd

3. GV Resolution Vessel Details

General Description and Dimensions:	Guard Vessel
Call Sign:	2CBT4
MMSI:	235002260
On Board Contact:	Master
Offshore Manager / Party Chief:	N/A
E-mail:	resolutionwy@gmail.com
Onshore Representative:	Marinecoordination.morayeast@morayeast.com



4. General Safety Advice

Users should consider the contents of this NtM when passage planning under the associated requirements of SOLAS V Regulation 34 and continue to comply with COLREGS at all times as a priority. Further guidance to mariners transiting in the vicinity of UK wind farms is provided in MCA Marine Guidance Note 372.

Mariners are requested to navigate with caution, to use all means appropriate to aid safe navigation as defined under COLREGs Rule 7, and keep continued watch on VHF Ch. 16, 87 and 73 when navigating the area.

5. Contact details

<u>CONTACT DETAILS</u>	
Marine Coordination Centre 24/7 Gary Smailes – Lead Marine Coordinator Email: garysmailes.morayeast@morayeast.com Tel : +44 7918750025/01346 511838	For fisheries related matters Alex Winrow-Giffin – Brown and May Marine Ltd. Email: alex@brownmay.com Tel : +44 1379 872144/ +44 7760 160039
Export Cable Package Manager Andrew Small Paul Mewse Email: andrew.small@morayeast.com Tel : +44 (0)7709 451 204	